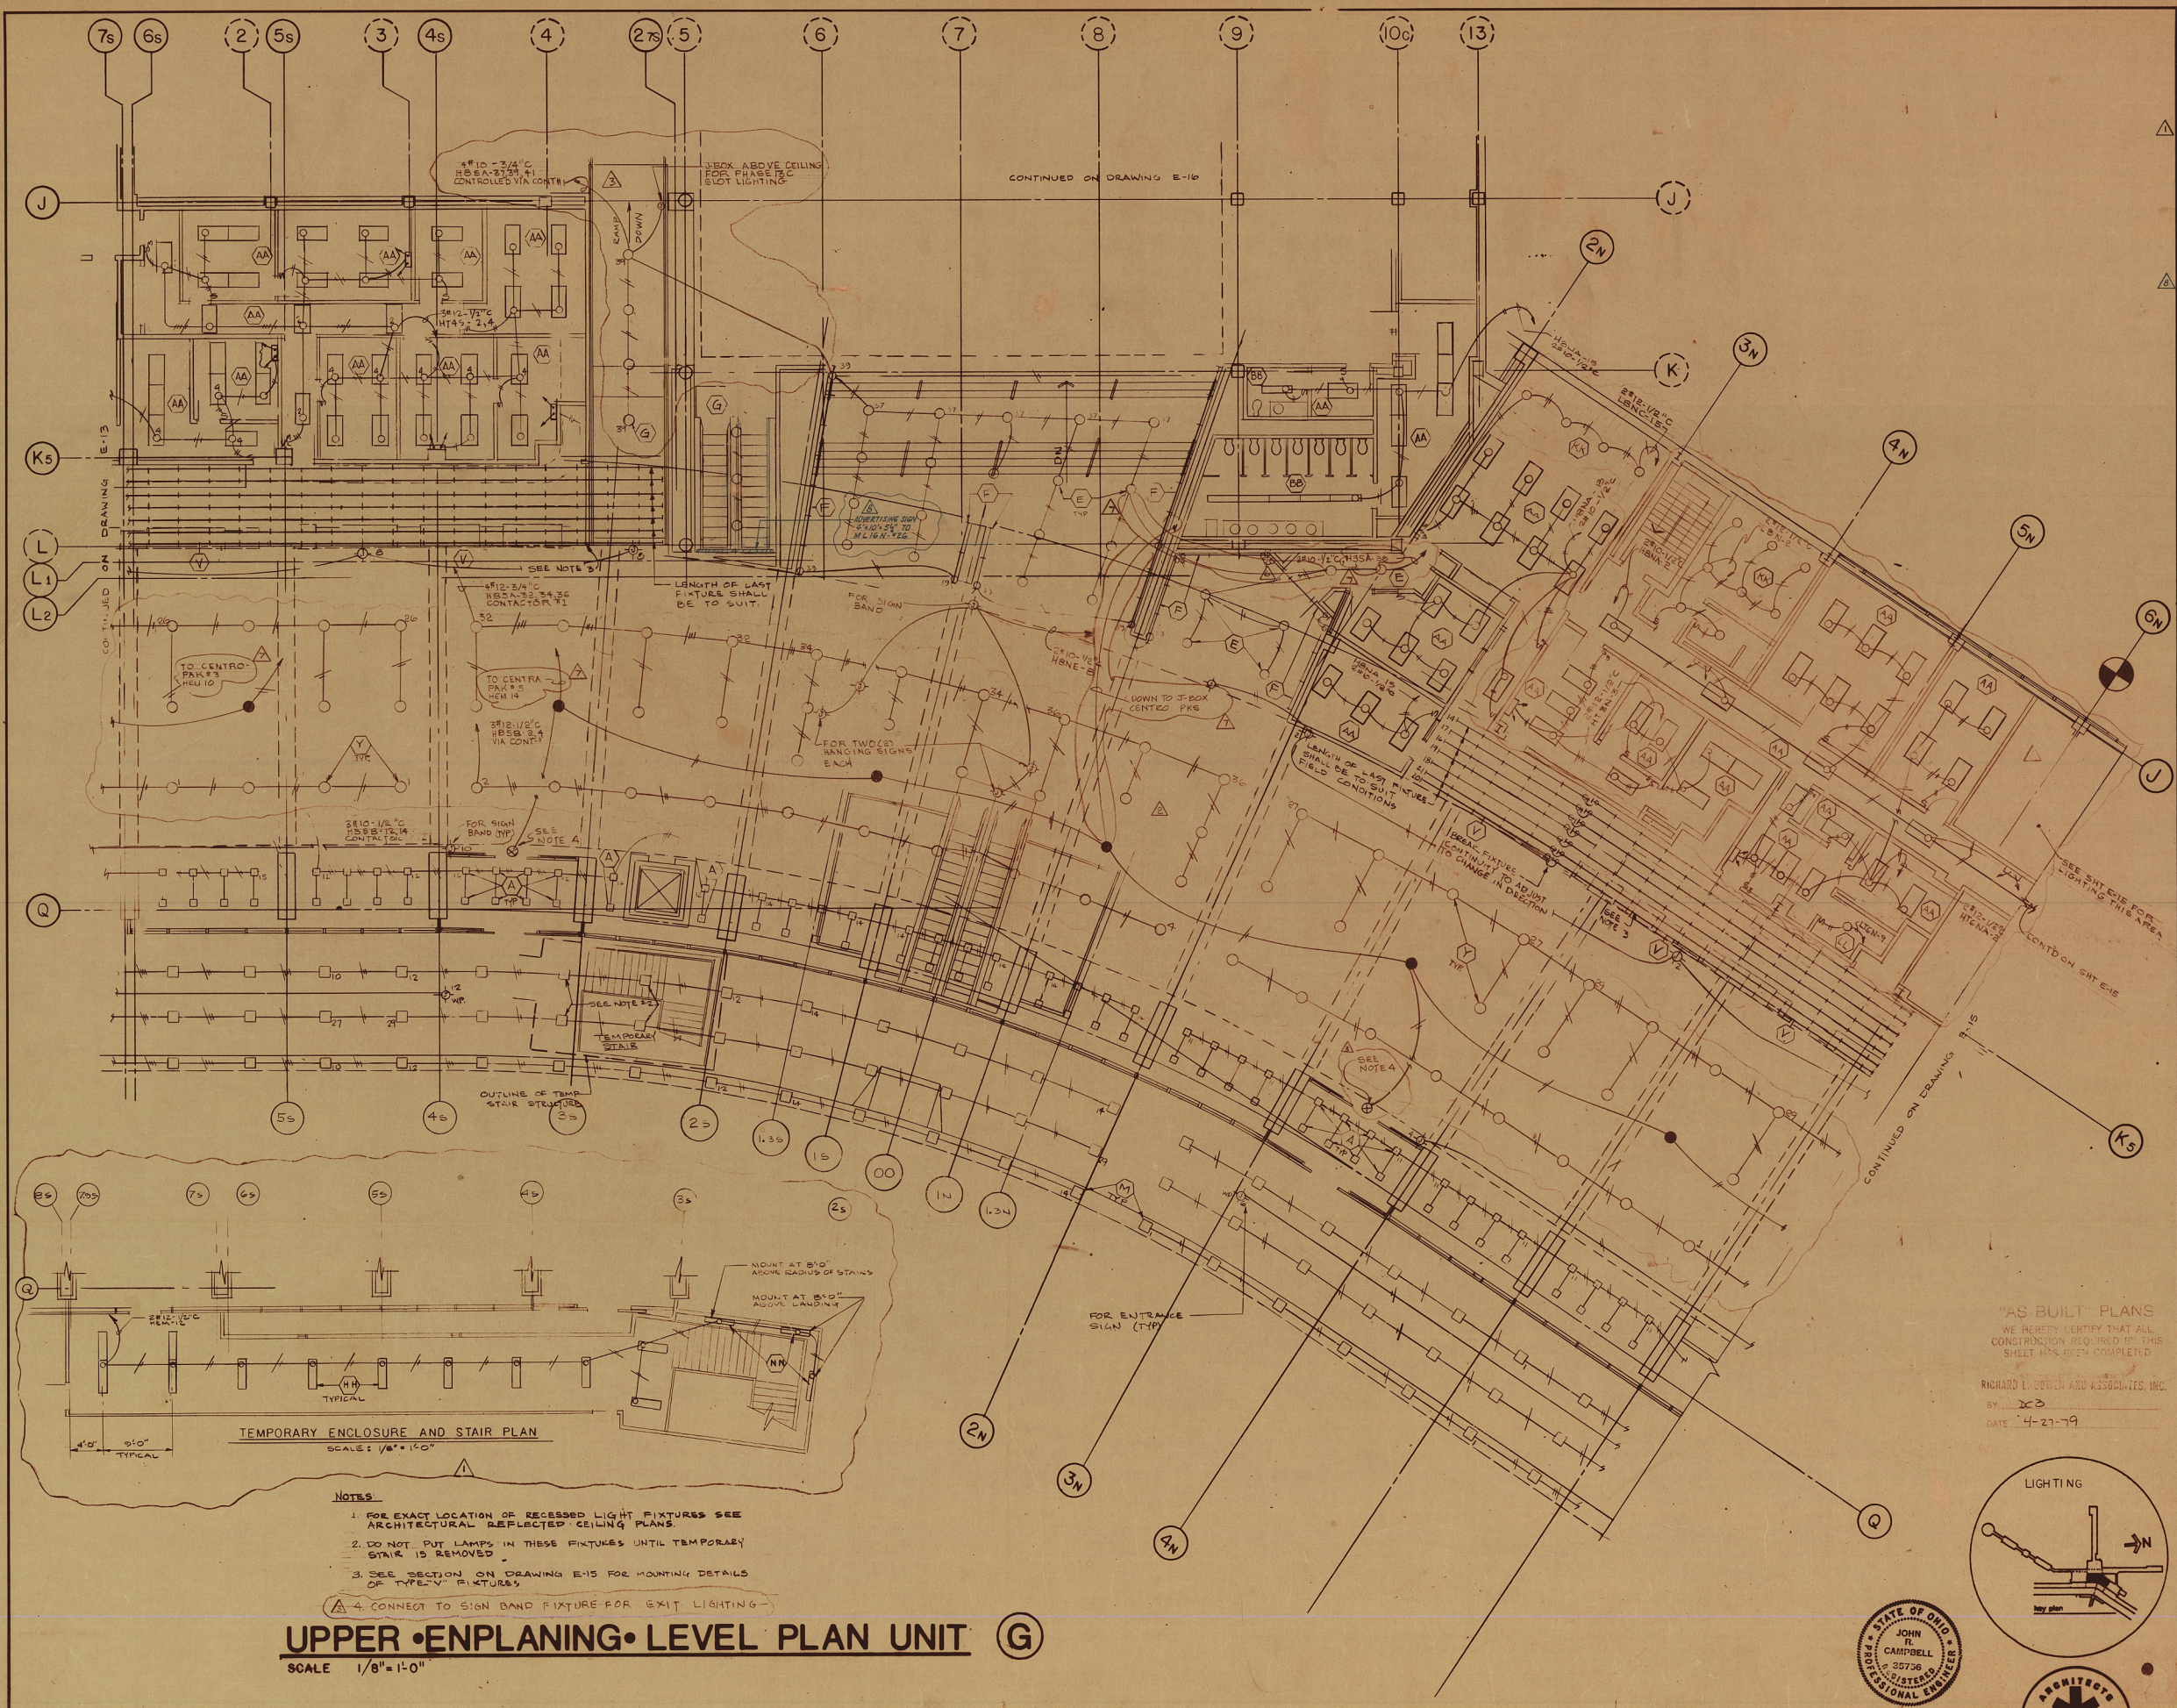

NOTES

1. FOR EXACT LOCATION OF RECESSED LIGHT FIXTURES SEE ARCHITECTURAL REFLECTED CEILING PLANS.
2. DO NOT PUT LAMPS IN THESE FIXTURES UNTIL TEMPORARY STAIR IS REMOVED.
3. SEE SECTION ON DRAWING E-15 FOR MOUNTING DETAILS OF TYPE "V" FIXTURES.
4. CONNECT TO SIGN BAND FIXTURE FOR EXIT LIGHTING.

UPPER •ENPLANING• LEVEL PLAN UNIT (G)

SCALE 1/8"=1'-0"

DATES AND REVISIONS	
10-9-75	
10-28-75 AIRLINE REVIEW	JRC
10-31-75 CM BST	JRC
11-17-75 ADDITION FOR CM BST	JRC
12-16-75 ISSUED TO CM	JRC
2-18-76 FOR BIDS	JRC
UPDATED THRU ADDN NO 3 4-23-76	JV
1 8-25-76 BULL #2	JRC
2 10-29-76 BULL #21	JRC
3 2-4-77 BULL #31	JRC
3-14-77 TEN REVIEW	TR
4 4-7-77 AIRLINE REVIEW	TR
5 4-7-77 CM REVIEW	
6 4-26-77 BULLETIN #36	TR
7 8/18/78 CHA BOW #49	JRC
8 AS BUILT 4-27-79 ADVERTISING SIGN 8-9-81	DCB L.D.E.

NOTICE

THIS ARCHITECTURAL AND ENGINEERING DRAWING IS GIVEN IN CONFIDENCE. NO USE OR DISSEMINATION MAY BE MADE WITHOUT PRIOR WRITTEN CONSENT OF THE ARCHITECT. ALL COMMON LAW RIGHTS OF COPYRIGHT AND OTHERWISE ARE HEREBY SPECIFICALLY RESERVED.

RLB JOB NO. 00875PF

STATE OF OHIO RICHARD L. BOWEN 3409 REGISTERED ARCHITECT

"AS BUILT" PLANS

WE HEREBY CERTIFY THAT ALL CONSTRUCTION REQUIRED BY THIS SHEET HAS BEEN COMPLETED

RICHARD L. BOWEN AND ASSOCIATES, INC.

BY DCB

DATE 4-27-79

STATE OF OHIO JOHN R. CAMPBELL 35736 REGISTERED PROFESSIONAL ENGINEER

phase 10 collector, north and south terminal buildings – electrical

cleveland hopkins international airport

terminal expansion

CHECKED BY JRC

DRAWN BY JRC

DRAWING NO. PHASE 10 E 14

RICHARD L. BOWEN + ASSOCIATES INC. CLEVELAND, OHIO